

LAND USE SUMMARY

LAND USE	LOTS / BLOCKS	UNITS	AREA
SINGLE DETACHED - 10.0m LOTS	001-047, 186-217, 233-310	177	6.13ha
SINGLE DETACHED - 11.6m LOTS	056, 083-153, 148-150	55	2.56ha
SINGLE DETACHED - 13.7m LOTS	048-055, 057-082, 134-147, 151-165, 218-232	78	4.71ha 4.70ha
TOWNHOUSE - 4 UNITS	311, 313-314, 316-318, 320-321, 323-324, 327-328, 333-340	80	1.74ha
TOWNHOUSE - 5 UNITS	343	5	0.10ha
TOWNHOUSE - 6 UNITS	312, 315, 319, 322, 325-326, 329-332, 341-342	72	1.46ha
COMMERCIAL	344		0.66ha 0.67ha
PARK	350-354, 356-360		2.42ha 2.48ha
SEWAGE PUMP	355		0.06ha
STORMWATER POND	361-363		4.19ha
OPEN SPACE	364-367		8.39ha 8.40ha
FUTURE RIGHT OF WAY	368-370		0.22ha
ROAD WIDENING	371		0.23ha
0.3m RESERVE	372		<0.01ha
OVERLAND FLOW / WALKWAY	345, 373-374		0.07ha 0.08ha
RIGHT OF WAY			7.27ha
TOTALS		467	40.22ha


LEGEND

--- BOUNDARY LINE	--- OVERHEAD HYDRO
--- RIGHT OF WAY LINE	--- FENCE
--- BLOCK LINE	--- WATERCOURSE
--- LOT LINE	--- WOODED AREA
--- UNIT LINE	--- TREES
--- LEGAL FABRIC	--- PHASE LINE

**PART OF LOTS 233 AND 234
CONCESSION 1, SOUTHWEST OF THE TORONTO AND SYDENHAM ROAD
GEOGRAPHIC TOWNSHIP OF PROTON
TOWNSHIP OF SOUTHGATE
COUNTY OF GREY**

OWNER'S CERTIFICATE
I HEREBY AUTHORIZE MACNAUGHTON HERMSEN BRITTON CLARKSON PLANNING LIMITED TO SUBMIT THIS PLAN FOR APPROVAL.
DATE: JANUARY 28, 2020
SHAKIR REHMATULLAH - PRESIDENT
FLATO DUNDALK MEADOWS INC.

SURVEYOR'S CERTIFICATE
I HEREBY CERTIFY THAT THE BOUNDARIES OF THE LAND TO BE SUBDIVIDED ON THIS PLAN AND THEIR RELATIONSHIP TO THE ADJACENT LANDS ARE ACCURATELY AND CORRECTLY SHOWN.
DATE: JANUARY 28, 2020
SEE PRIOR SUBMISSION

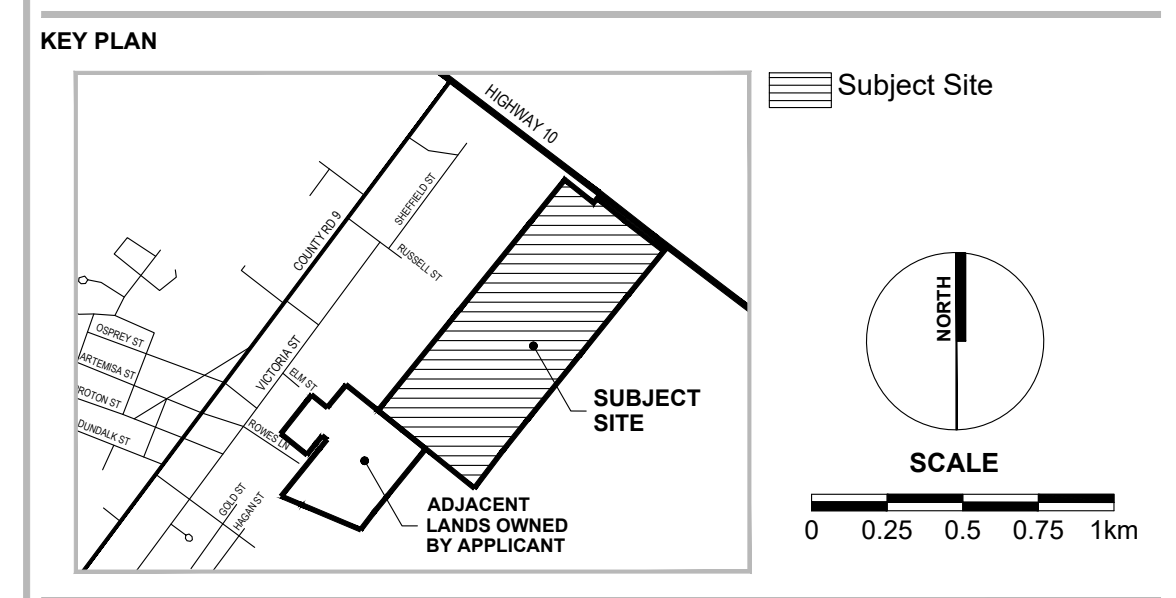

- NO. 6** Jul. 13, 2021
- Shift lots 090-098 to accommodate overland flow / walkway Block 374
 - Convert Block 355 from park to sewage pumping station and expand
 - Add 6m water service easement between Lot 232 and Block 339 by shifting Blocks 339-343 the commercial Block 344
- NO. 5** Jan. 28, 2020
- Removed townhouses along Streets J & G
 - Added Commercial block
 - Realigned Street G
 - Added registered phases
 - Added surrounding registered subdivisions
- NO. 4** Nov. 1, 2019
- Moved walkway from between lots 051 & 052 to between lots 055 & 056
 - Widened walkway from 3m to 4m
 - Narrowed lot 056 from 13.6m to 12.7m
- NO. 3** Mar. 13, 2019
- Widened Block 362 street frontage
 - Revised lots backing on to Block 362
 - Shifted Street D west by 2m and adjust lots to fit
- NO. 2** Feb. 9, 2017
- Widened Hydro Easement
 - Added daylighting triangles to Future R.O.W.
 - Added Overland Flow/Walkway Block 372
 - Added Park Block 350
 - Remove one Lot
 - Rearrange Lots to fit
 - Revised labels and dimensions
- NO. 1** Jul. 5, 2016
- Revised as per MTO comments March 17, 2016
 - Added road widening, 0.3m reserve, and daylighting triangles
 - Relocated Highway 10 entrance and future right of ways
 - Reorganized subdivision layout along Highway 10
 - Added walkways to Open Space
- NO. 0** Dec. 11, 2015
- Draft Plan Application Submission

ADDITIONAL INFORMATION REQUIRED UNDER SECTION 51(17) OF THE PLANNING ACT R.S.O. 1990 C.P.13 AS AMENDED

A. AS SHOWN	F. AS SHOWN	K. MUNICIPAL WATER AND SANITARY SERVICES. ALL REQUIRED.
B. AS SHOWN	G. AS SHOWN	H. MUNICIPAL WATER SUPPLY REQUIRED.
C. AS SHOWN	I. SILT LOAM	L. AS SHOWN
D. RESIDENTIAL / COMMERCIAL	J. AS SHOWN	
E. AS SHOWN		

PLANNING URBAN DESIGN & LANDSCAPE ARCHITECTURE MHC PLANING
113 COLLIER STREET
BARRIE, ON, L4M 1H2
P: 705 728 0045 F: 705 728 2010
WWW.MHCPLAN.COM

STAMP

DATE: DEC. 11, 2015
FILE No.: 15184B
SCALE: 1:1,800 (ARCH D)
DRAWN BY: M.M.
CHECKED BY: K.M.

PROJECT

FLATO EAST
FLATO GROUP INC.
3621 HIGHWAY 7 EAST, SUITE 503
MARKHAM, ON L3R 0G6
P:(905) 479-9292 F:(905) 429-9165
WWW.FLATOGROUP.COM

FILE NAME REDLINE
DRAFT PLAN OF SUBDIVISION

DWG No. 1 of 1

