

COMPILED DRAFT PLAN  
OF  
PROPOSED SUBDIVISION

PART OF LOT 17  
CONCESSION 3  
PART OF LOT A, REG. PLAN 171  
TOWNSHIP OF GEORGIAN BLUFFS  
(FORMERLY TOWNSHIP OF SARAWAK)  
COUNTY OF GREY

OWNER'S CERTIFICATE

I, the registered owner of these lands, hereby authorize GM BluePlan Engineering Limited to submit this draft plan for approval.

SIGNED \_\_\_\_\_


DATE \_\_\_\_\_

SURVEYOR'S CERTIFICATE

I hereby certify that the boundaries of the lands to be subdivided as shown on this plan and their relationship to the adjacent lands are accurately and correctly shown.

DATE \_\_\_\_\_

ONTARIO LAND SURVEYOR

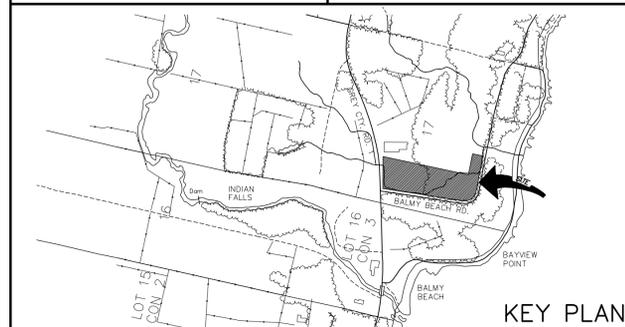

~~PROPOSED DEVELOPMENT~~

<del>SINGLE FAMILY RESIDENTIAL LOTS (9)</del>	<del>3.84 ha</del>
<del>BLOCK 10 - LANDS TO BE DEEDED TO MUNICIPALITY</del>	<del>0.30 ha</del>
<del>0.3m RESERVE BLOCKS (11 &amp; 13)</del>	<del>0.02 ha</del>
<del>BLOCK 12 - LANDS TO BE DEEDED TO MUNICIPALITY</del>	<del>0.04 ha</del>
<del>BLOCK 14 - PROPOSED DAYLIGHTING</del>	<del>0.05 ha</del>
<del>TOTAL AREA</del>	<del>4.25 ha</del>

PROPOSED DEVELOPMENT

SINGLE FAMILY RESIDENTIAL LOTS (9)	3.64 ha
BLOCK 10 - LANDS TO BE DEEDED TO MUNICIPALITY	0.30 ha
0.3m RESERVE BLOCKS (11 & 13)	0.02 ha
BLOCK 12 - LANDS TO BE DEEDED TO MUNICIPALITY	0.21 ha
BLOCK 14 - LANDS TO BE DEEDED TO THE COUNTY OF GREY	0.08 ha
TOTAL AREA	4.25 ha

PLANNING ACT SEC.51 (17)

- |                            |   |
|----------------------------|---|
| a) See plan                | i) Sandy clay loam & gravel                                       |
| b) See plan                | j) See plan   |
| c) See plan                | k) Hydro, telephone, snow removal<br>garbage collection and cable |
| d) Single family dwellings | l) None   |
| e) See plan                |   |
| f) See plan                |   |
| g) See plan                |   |
| h) Municipal Water Supply  |   |

OWNERS:

1758506 ONTARIO INC.  
319026 GREY ROAD 1  
KEMBLE, ONTARIO  
N4K 0G2

TEL. 519-372-6895 (CHRIS)  
519-372-8859 (JENNIFER)

DRAWING No.

DP-1



MAY 9, 2018

PROJECT No. 217215

